


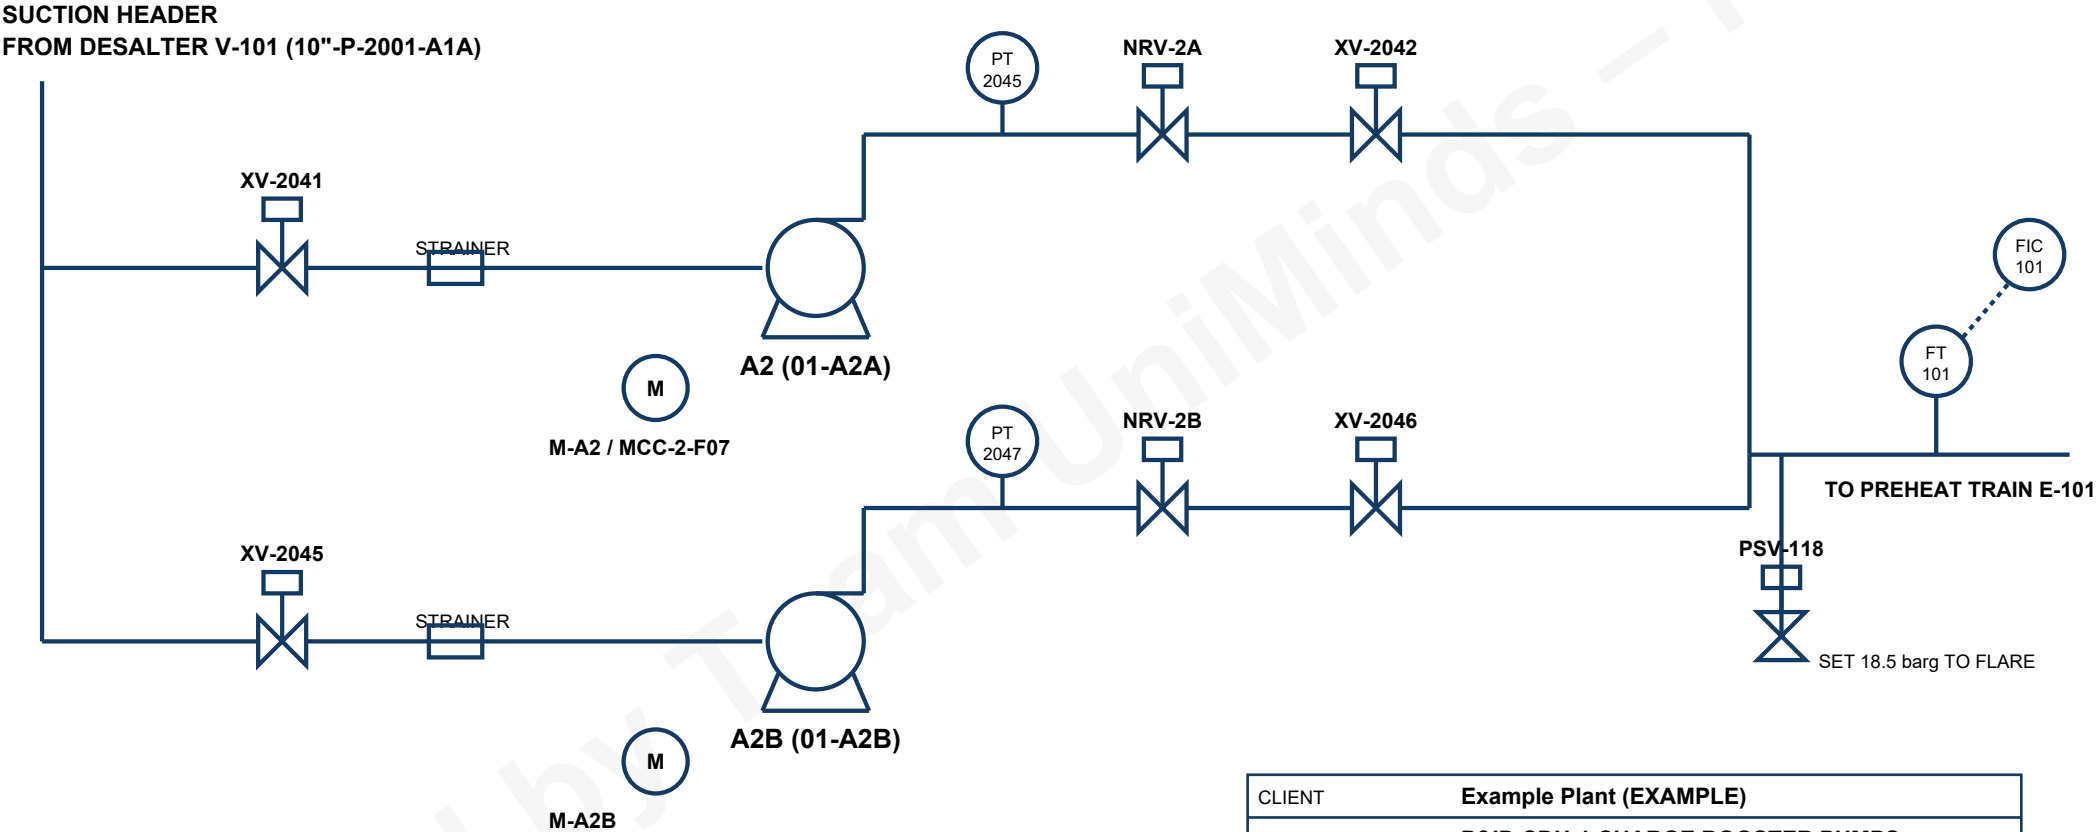

CLIENT	Example Plant (EXAMPLE)	
TITLE	P&ID CDU-1 CHARGE BOOSTER PUMPS	
	A2 / A2B	
DWG NO	PID-CDU-03	
REV	B	
DATE	2022-08-05	
STATUS	SUPERSEDED	
REV	DATE	DESCRIPTION
A	2016-03-10	Issued for construction
B	2022-08-05	As-built update, A2/A2B tags