


INCOMER FROM TR-03, 1600 kVA, 6.6/0.433 kV, Dyn11

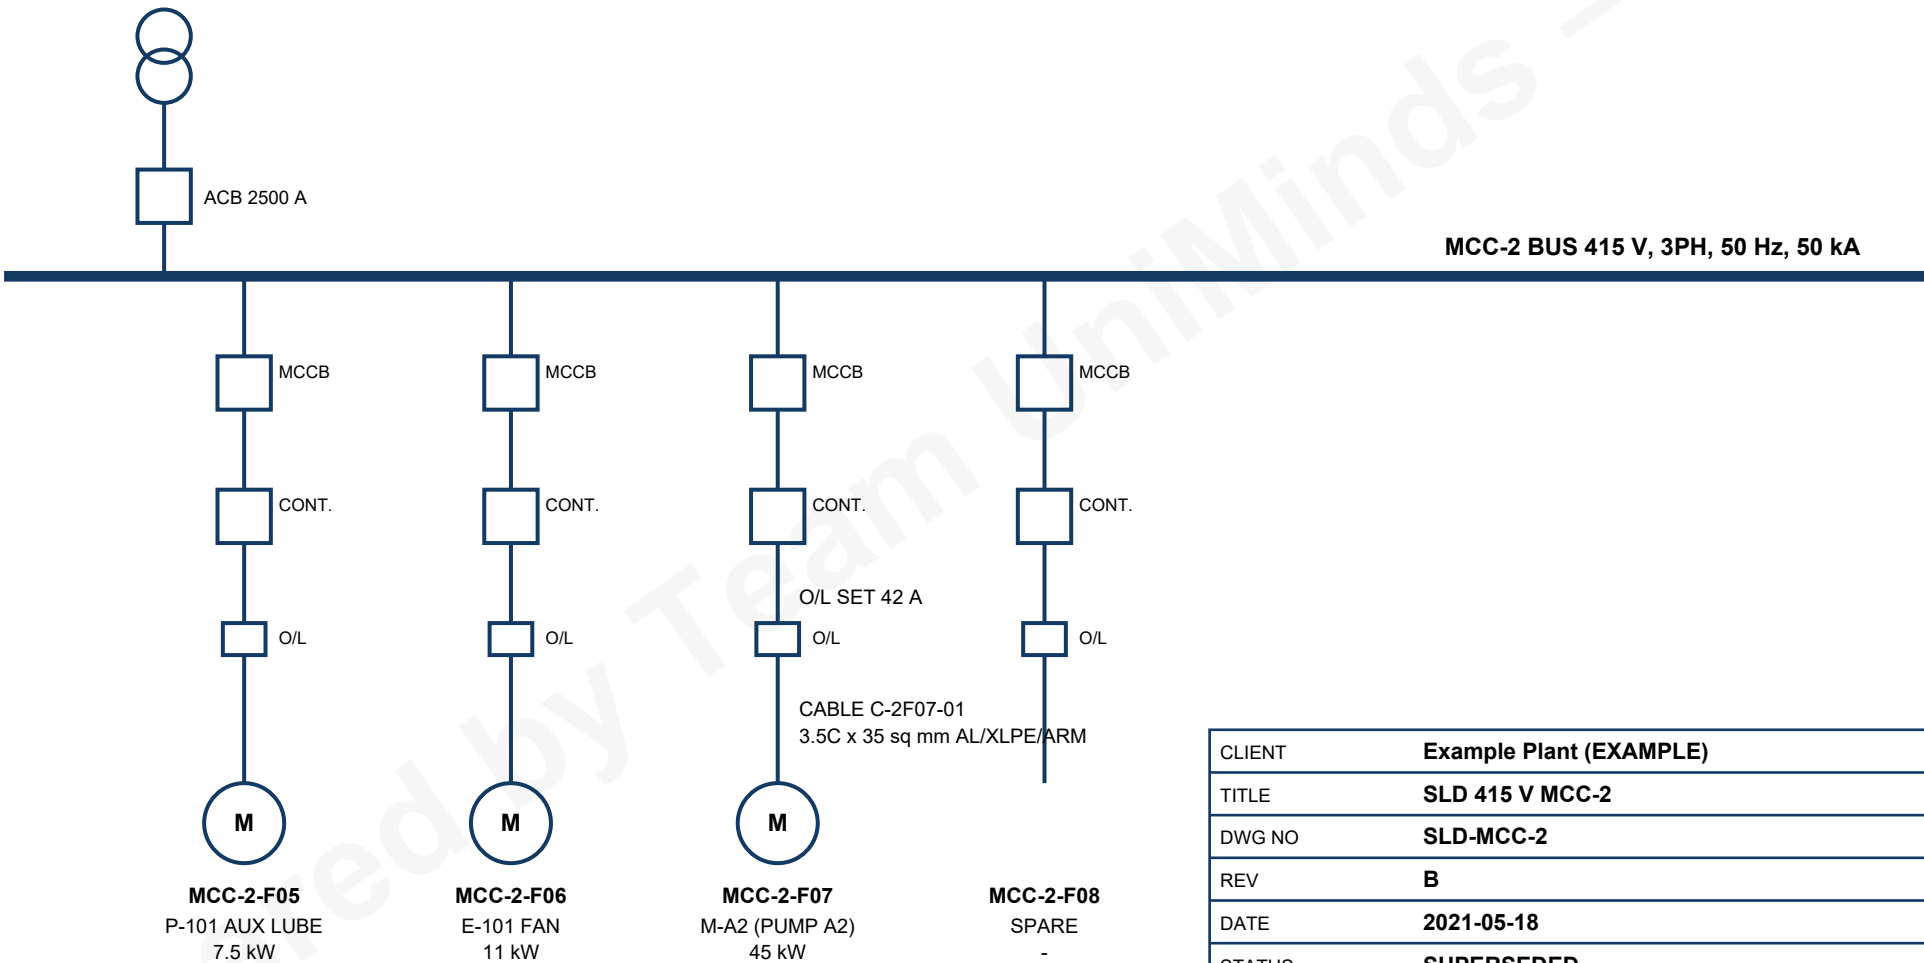

FEEDER SCHEDULE – MCC-2-F07

Feeder: MCC-2-F07 Load: motor M-A2 (pump A2, CDU-1), 45 kW, 415 V, FLA 78 A, DOL  
MCCB 125 A (Im 10x) Contactor 95 A AC-3 Thermal overload relay setting: 42 A  
Cable: C-2F07-01, 3.5C x 35 sq mm Al XLPE armoured, route length 145 m, via tray T-2-07  
Local control station: LCS-A2 (START/STOP, lockable STOP) near pump A2

|        |                         |                                      |
|--------|-------------------------|--------------------------------------|
| CLIENT | Example Plant (EXAMPLE) |                                      |
| TITLE  | SLD 415 V MCC-2         |                                      |
| DWG NO | SLD-MCC-2               |                                      |
| REV    | B                       |                                      |
| DATE   | 2021-05-18              |                                      |
| STATUS | SUPERSEDED              |                                      |
| DEPT   | Electrical              |                                      |
| REV    | DATE                    | DESCRIPTION                          |
| A      | 2016-01-12              | Issued for construction              |
| B      | 2021-05-18              | As-built update, F07 feeder schedule |