


SUCTION HEADER
FROM DESALTER V-101 (10"-P-2001-A1A)

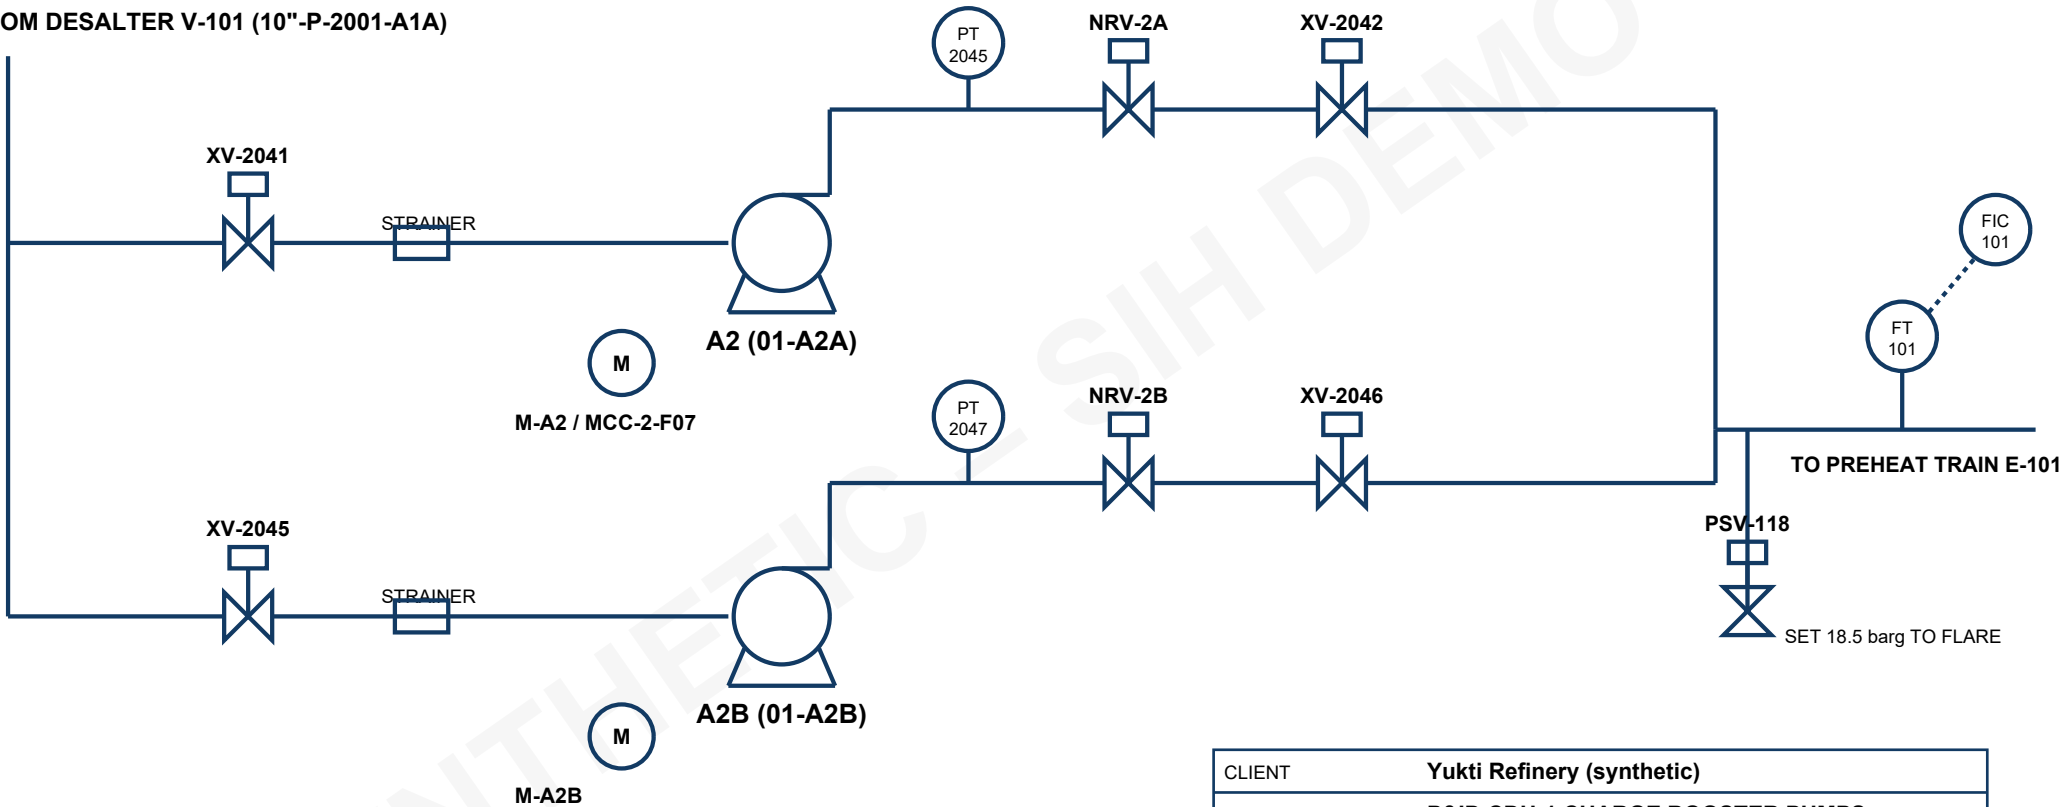

NOTES: 1. Seal flush API 682 Plan 11 on A2/A2B. 2. Min-flow via FIC-101 to V-101.
3. A2 discharge isolation valve: XV-2042. A2 suction isolation: XV-2041.

CLIENT	Yukti Refinery (synthetic)	
TITLE	P&ID CDU-1 CHARGE BOOSTER PUMPS	
	A2 / A2B	
DWG NO	PID-CDU-03	
REV	B	
DATE	2022-08-05	
STATUS	SUPERSEDED	
REV	DATE	DESCRIPTION
A	2016-03-10	Issued for construction
B	2022-08-05	As-built update, A2/A2B tags