


INCOMER FROM TR-03, 1600 kVA, 6.6/0.433 kV, Dyn11

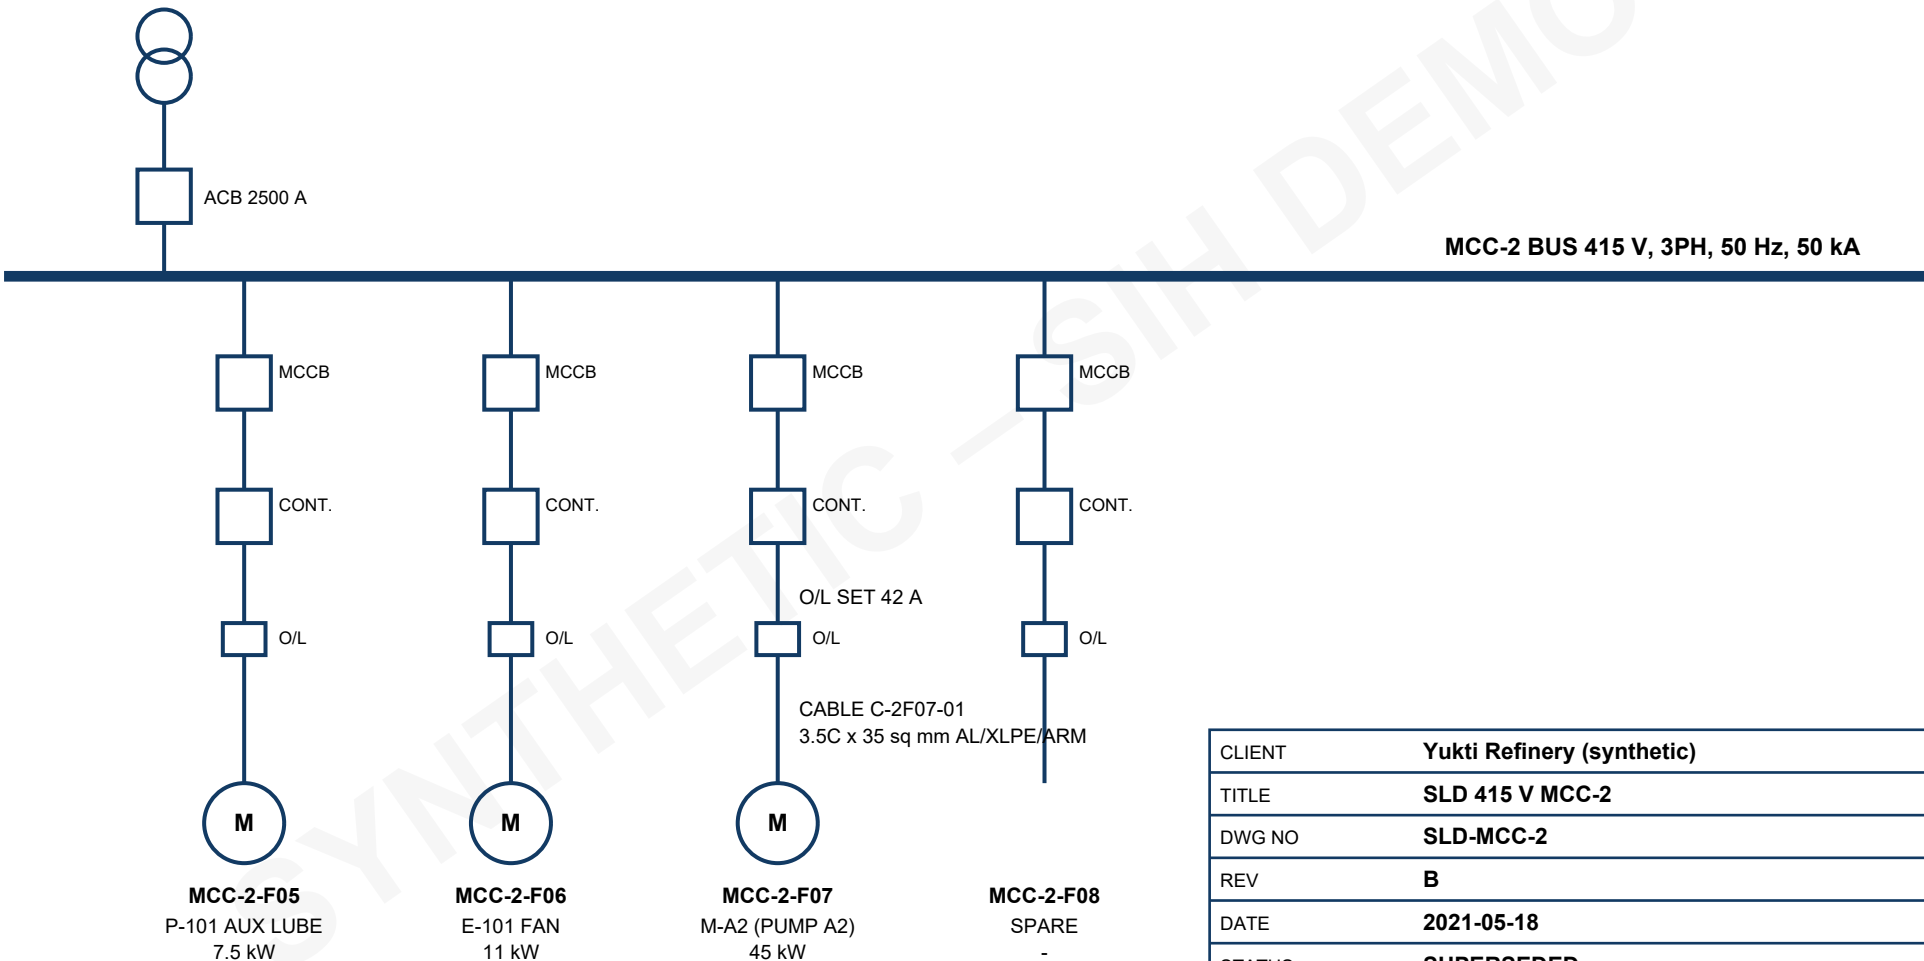

FEEDER SCHEDULE – MCC-2-F07

Feeder: MCC-2-F07 Load: motor M-A2 (pump A2, CDU-1), 45 kW, 415 V, FLA 78 A, DOL
MCCB 125 A (Im 10x) Contactor 95 A AC-3 Thermal overload relay setting: 42 A
Cable: C-2F07-01, 3.5C x 35 sq mm Al XLPE armoured, route length 145 m, via tray T-2-07
Local control station: LCS-A2 (START/STOP, lockable STOP) near pump A2

CLIENT	Yukti Refinery (synthetic)	
TITLE	SLD 415 V MCC-2	
DWG NO	SLD-MCC-2	
REV	B	
DATE	2021-05-18	
STATUS	SUPERSEDED	
DEPT	Electrical	
REV	DATE	DESCRIPTION
A	2016-01-12	Issued for construction
B	2021-05-18	As-built update, F07 feeder schedule